



FILE NAME: P:\Proj\130\130870\10_Dwg\CAD\S-3.1 Facility Plan.dwg PLOT TIME: Fri, 07 Mar 2014 - 6:30pm LAST SAVE: Fri, 07 Mar 2014 - 6:25pm BY: echiu

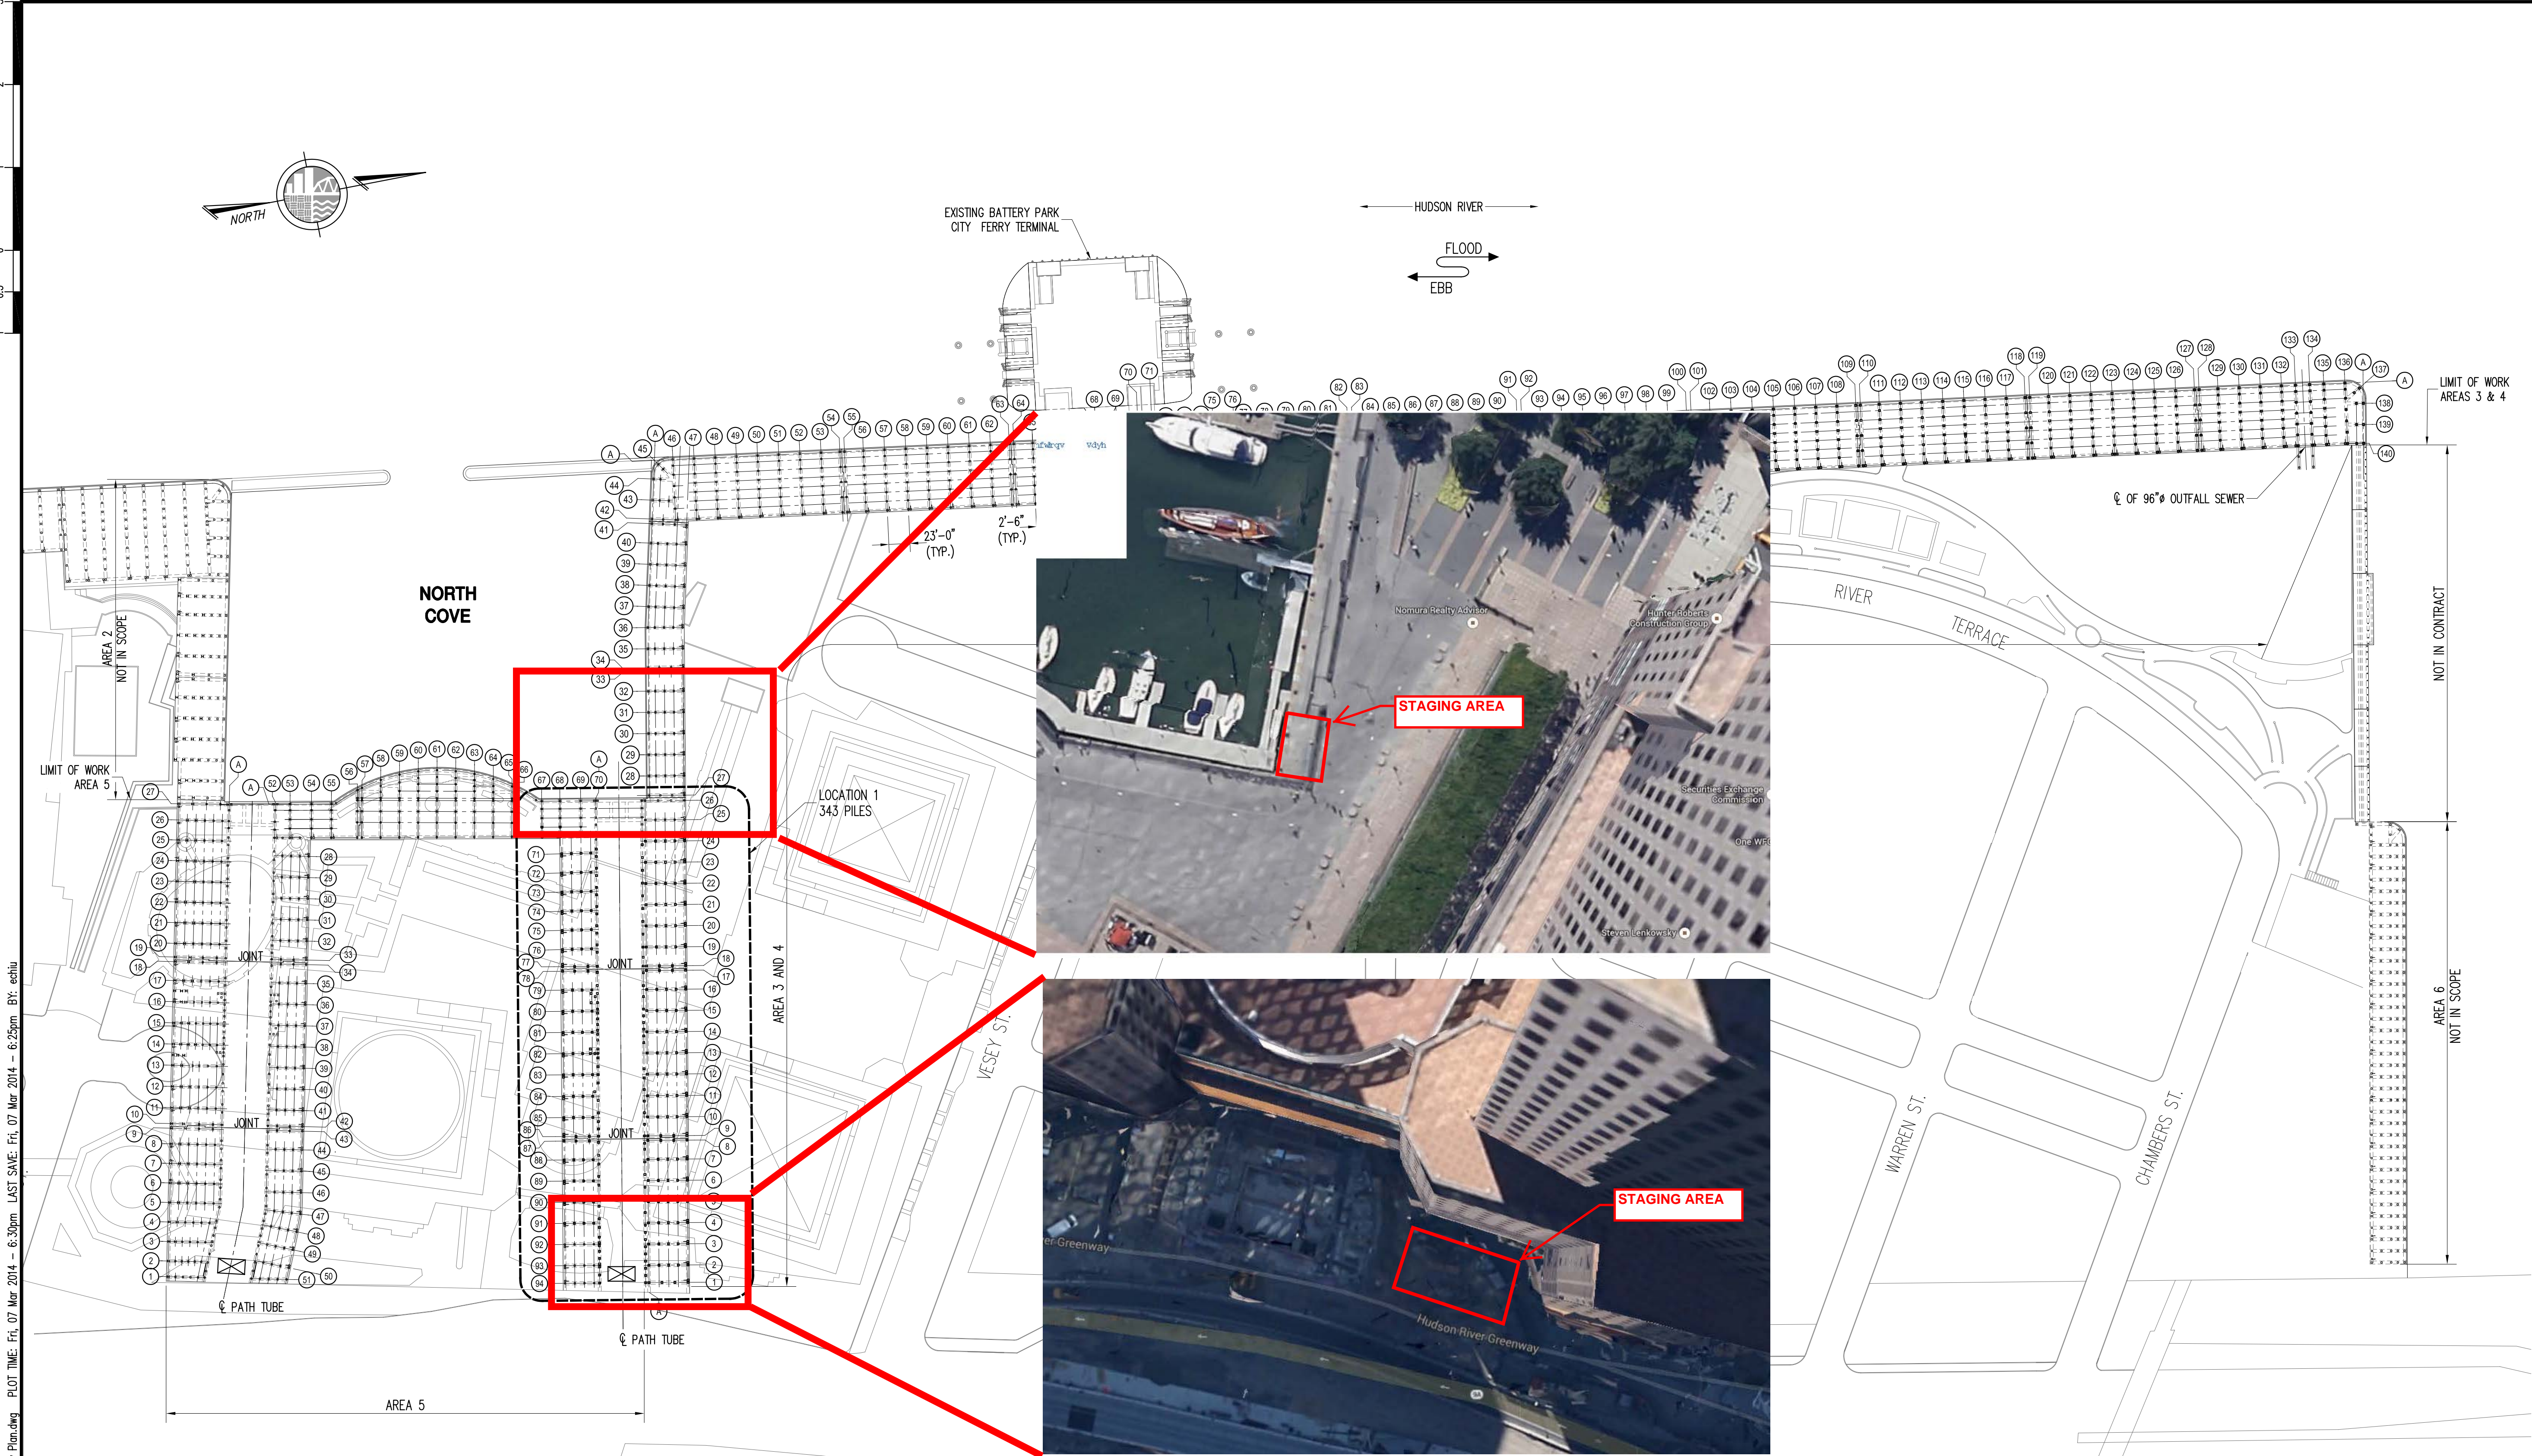

FACILITY PLAN

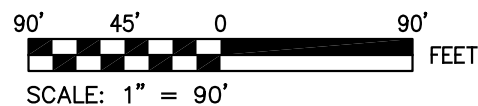

- LEGEND:
- 20" x 20" SQUARE PRESTRESSED CONCRETE PILE
 - 20" x 20" SQUARE PRESTRESSED CONCRETE BATTER PILE

NOTE: AREA DESIGNATIONS TAKEN FROM AS-BUILT "BATTERY PARK CITY" DRAWINGS DEVELOPED BY MUESER, RUTLEDGE, WENTWORTH, AND JOHNSTON CONSULTING ENGINEERS, DATED JUNE 17, 1974.

BID SET
NOT FOR CONSTRUCTION

COPYRIGHT © 2014, McLAREN ENGINEERING GROUP

PROJECT NO. 130870	
SCALE AS NOTED	
DATE 03/07/2014	
DRAWN BY EHC	
CHECKED BY RJM	
DRAWING NO. S-3.1	
4 OF 8 SHES	

PROJECT	
BATTERY PARK CITY ESPLANADE REPAIRS	
NEW YORK	
MANHATTAN	
PROJECT	
BATTERY PARK CITY ESPLANADE REPAIRS	
NEW YORK	
MANHATTAN	

McLaren	
ENGINEERING GROUP	
M. G. McLAREN, P.C.	
100 Shake Hill Road, West Nyack, NY 10994	
T: (947) 353-5400 F: (947) 353-5509 www.mgmclaren.com	

PERSON	
DATE	
BY	